



PARKING SPACE ASSIGNMENTS NORTH VILLAS SEPTEMBER 27, 2004

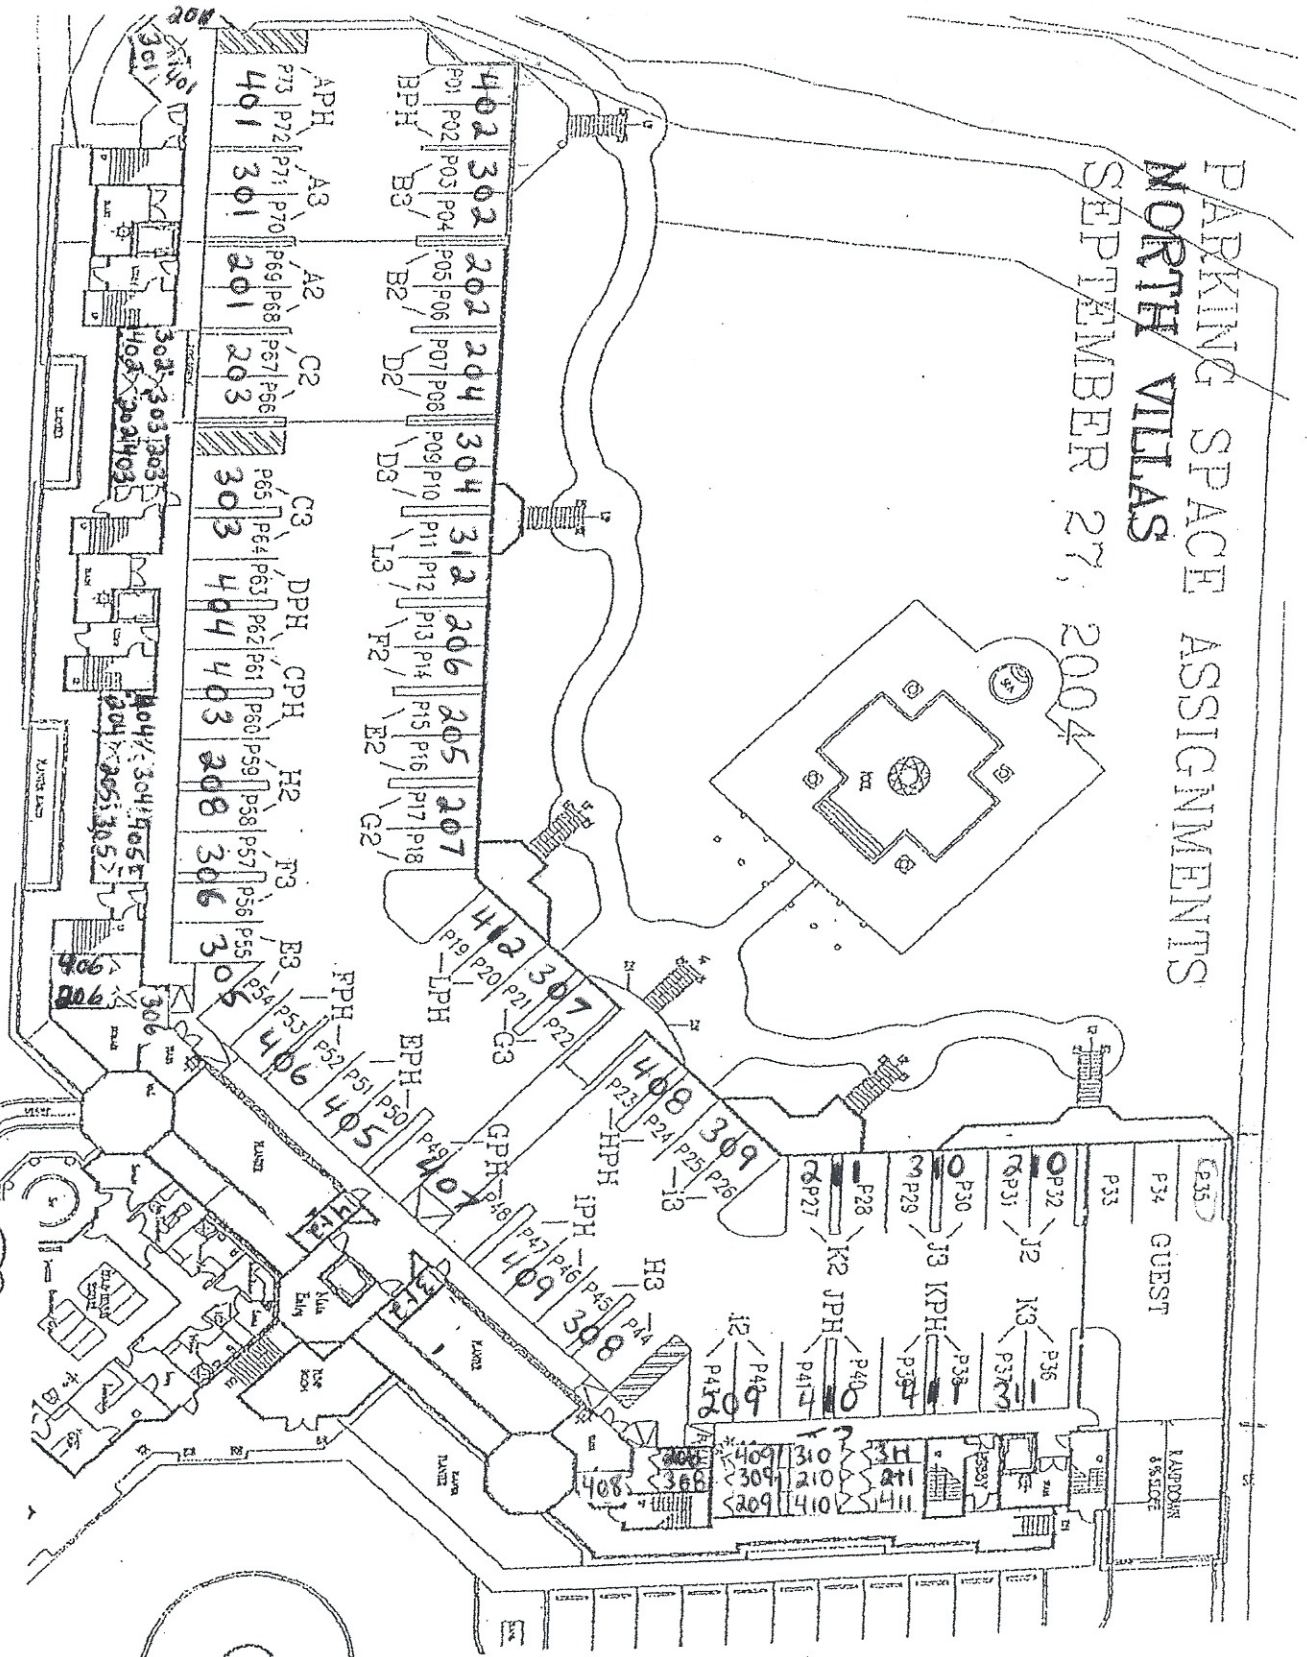

Bellagio
Harbor Village

1995/21

PARKING SPACE ASSIGNMENTS SOUTH VILLAS SEPTEMBER 27, 2004

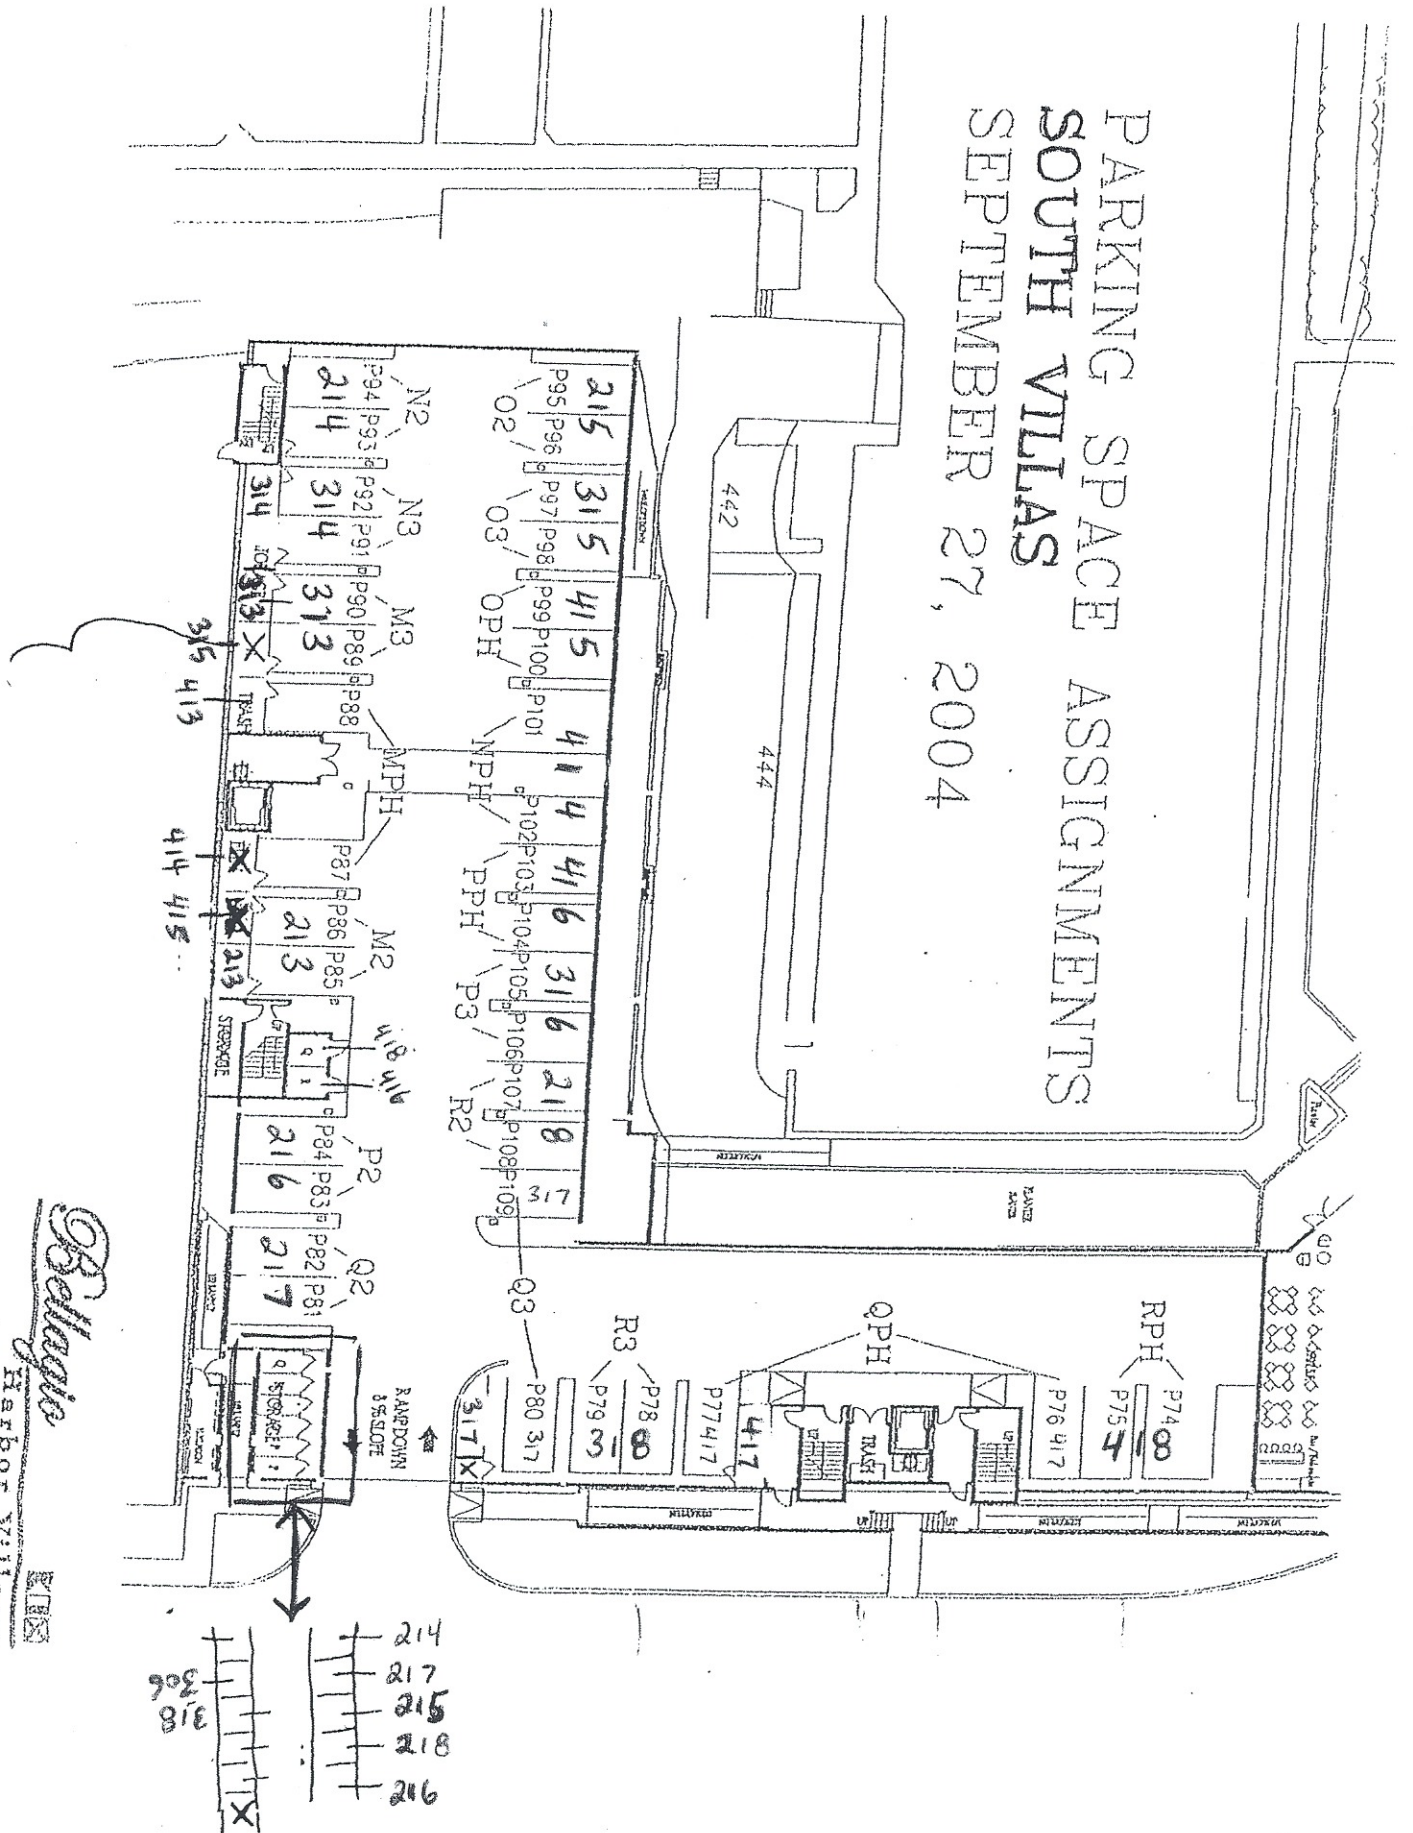

Bellagio
Harbor Villas